


EXISTING SOUTH ELEVATION

SCALE 1:200




EXISTING EAST ELEVATION

EXISTING
SCALE 1:200

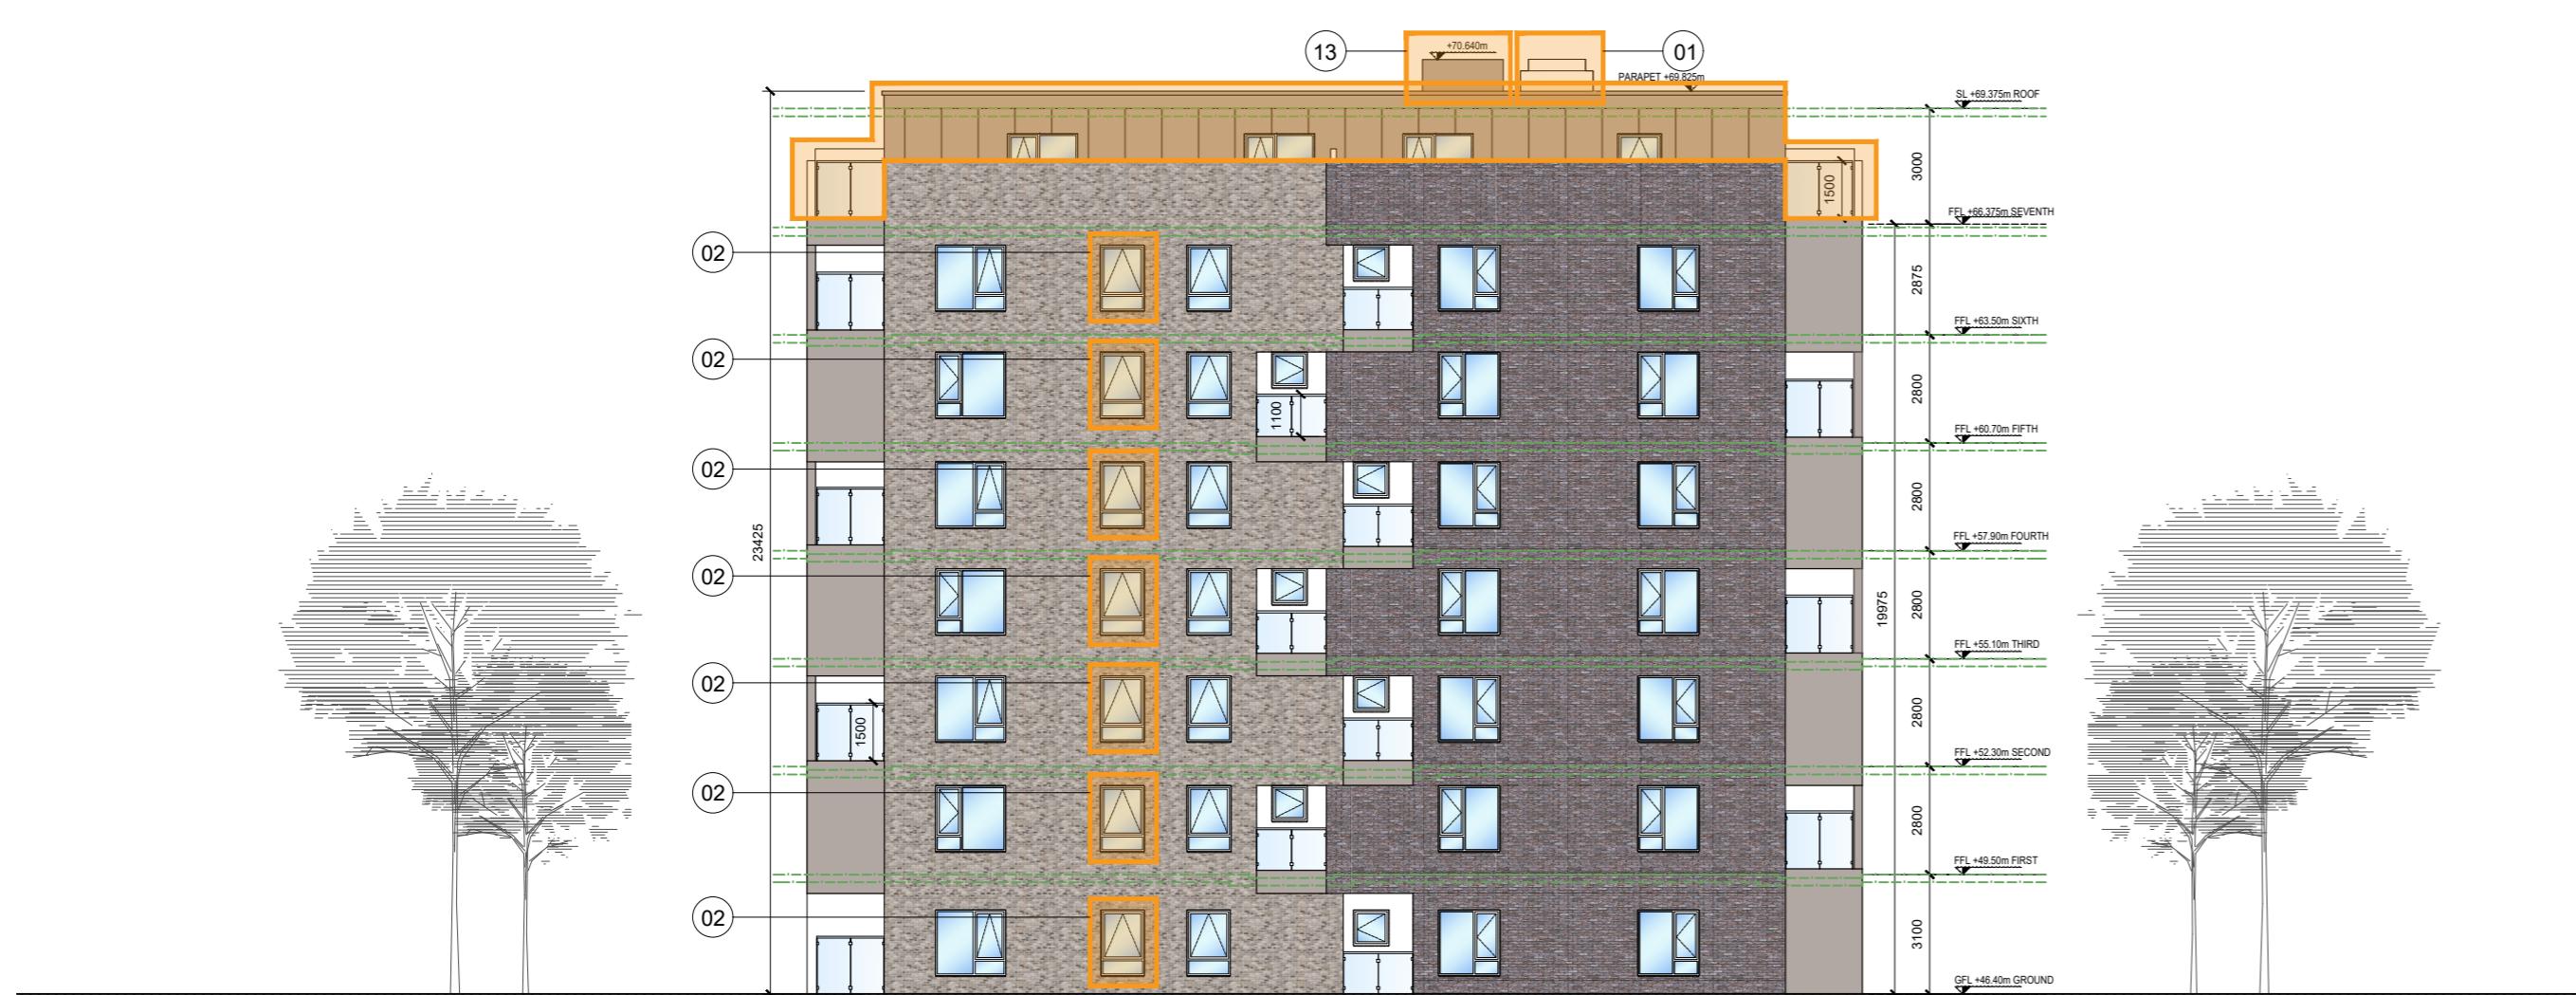

EXISTING NORTH ELEVATION

EXISTING

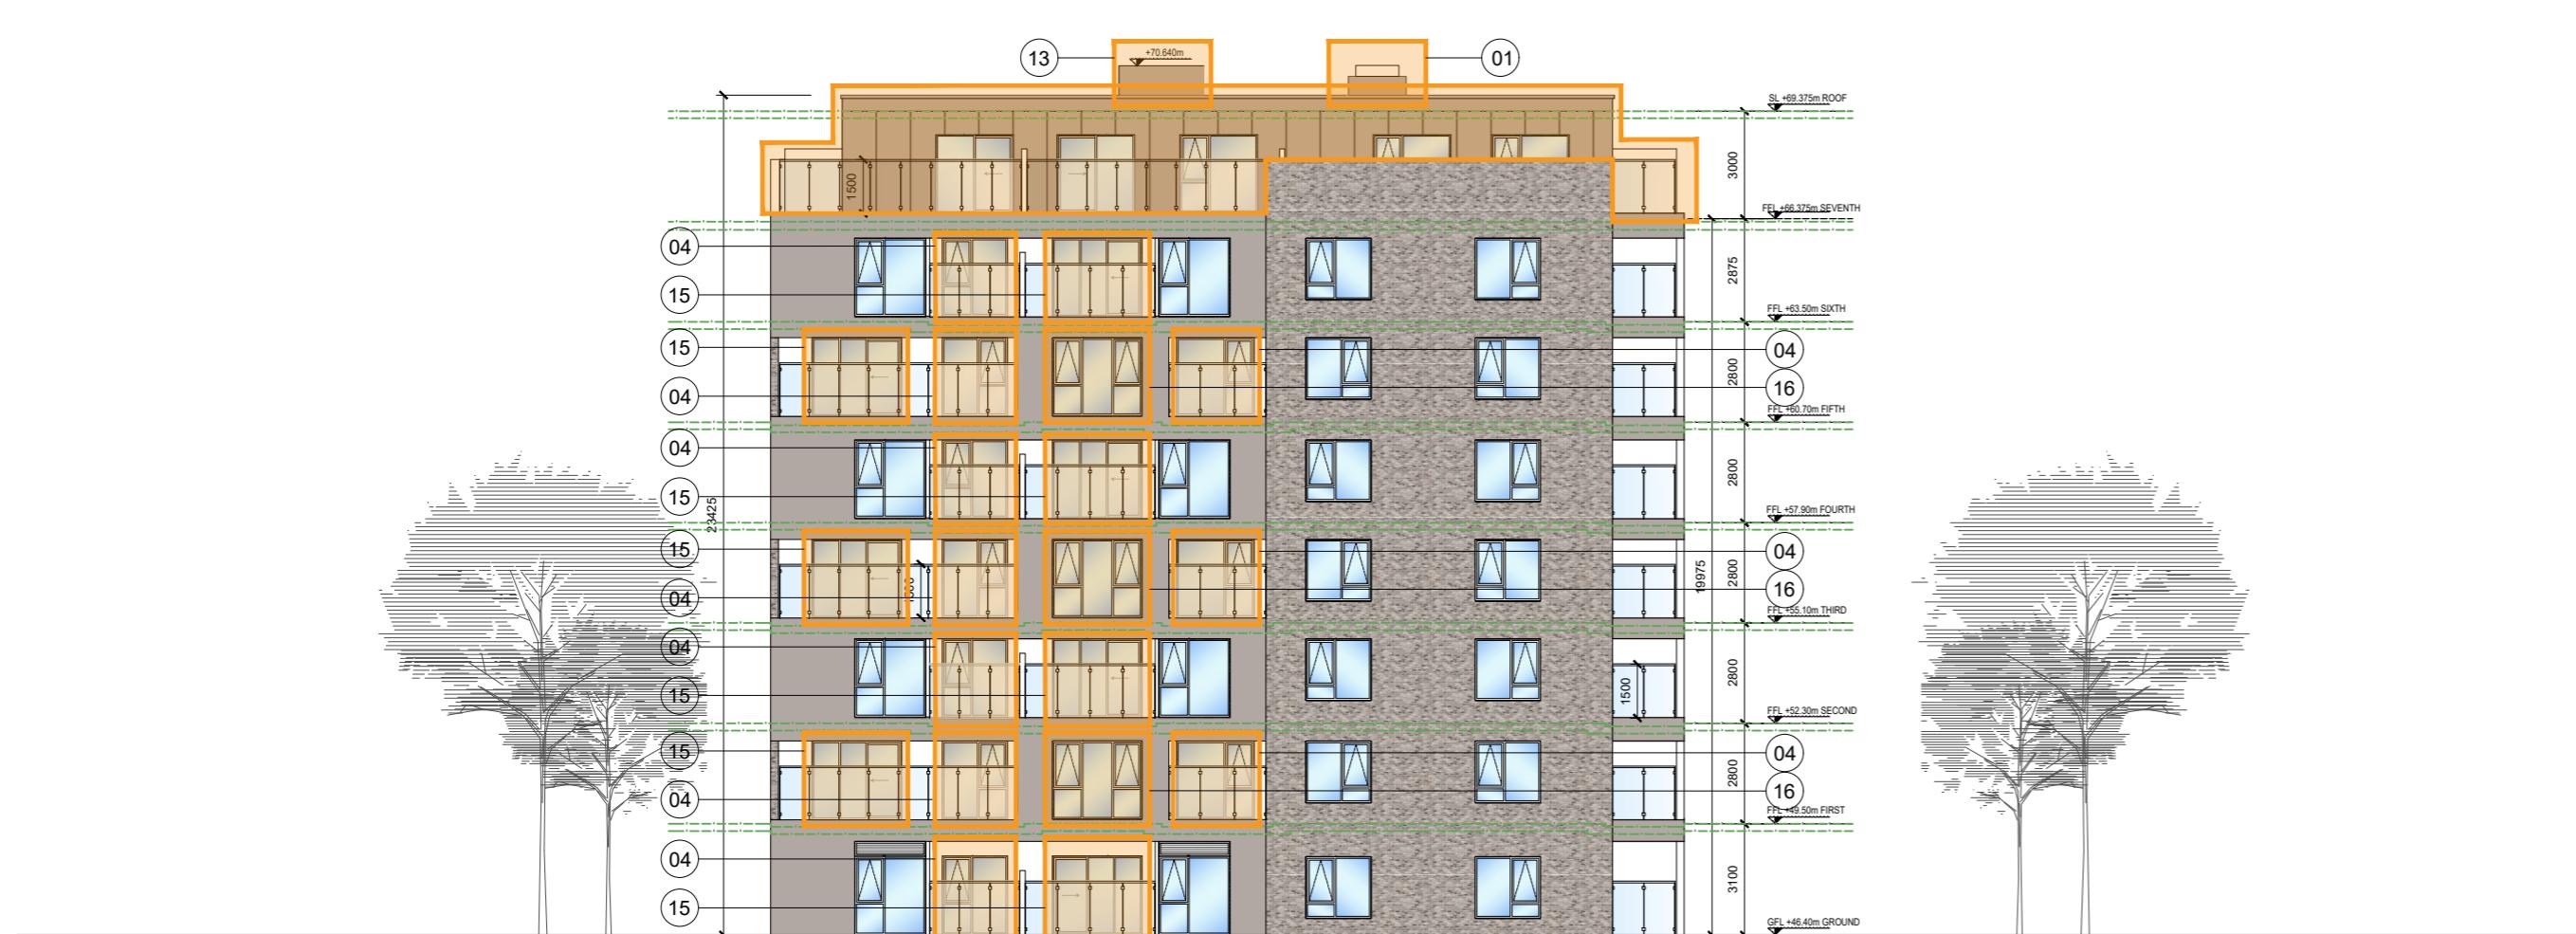

EXISTING WEST ELEVATION

EXISTING
SCALE 1:200



KEY PLAN

EXISTING SECTION A-A

COMPARISON - AS GRANTED SCHEME X EXISTING SCHEME

01 - AS GRANTED: SIMPLE ACCESS TO THE UNITS;
EXISTING: THE CORRIDOR LAYOUT HAS BEEN RECONFIGURED DUE TO THE INCLUSION OF AOV;

02 - AS GRANTED: PROVISION ONE WINDOW FOR THE LIVING AREA;
EXISTING: A NEW WINDOW WAS BUILT DUE TO A CHANGE IN THE KITCHEN LAYOUT;

03 - AS GRANTED: PROVISION OF A TRIPLE SLIDING DOOR;
EXISTING: A DOUBLE SLIDING DOOR WAS BUILT;

04 - AS GRANTED: PROVISION OF A DOUBLE SLIDING DOOR;
EXISTING: A DOUBLE OPENING WINDOW WAS BUILT;

05 - AS GRANTED: OPENING THE ACCESS DOOR FROM THE RIGHT;
EXISTING: MAIN ACCESS DOOR OPENING CHANGED TO THE LEFT;

06 - AS GRANTED: PROVISION OF A DOUBLE SLIDING DOOR;
EXISTING: A SINGLE OPENING WINDOW WAS BUILT;

07 - AS GRANTED: NO ACCESS TO OPEN SPACE;
EXISTING: A SINGLE DOOR WAS BUILT TO ACCESS THE NEW BALCONY;

08 - AS GRANTED: PROVISION OF A WINDOW;
EXISTING: A DOOR WAS BUILT TO ACCESS THE BALCONY;

09 - AS GRANTED: PROVISION OF A DOUBLE SLIDING DOOR;
EXISTING: A DOUBLE OPENING WINDOW WAS BUILT;

10 - AS GRANTED: PROVISION OF A DOUBLE SLIDING DOOR;
EXISTING: A TRIPLE SLIDING DOOR WAS BUILT INCREASING THE DIMENSIONS OF THE OPENING;

11 - AS GRANTED: PROVISION OF A DOUBLE SLIDING DOOR;
EXISTING: LARGER DOUBLE SLIDING DOOR WAS BUILT;

12 - AS GRANTED: PROVISION OF WINDOW AND DOOR OPENINGS FOR A PENTHOUSE LAYOUT FOR 3 No. 2-BEDS UNITS AND 4 No. 1-BED UNITS;
EXISTING: LAYOUT HAS BEEN RECONFIGURED TO A PENTHOUSE WITH 1 No. 2-BEDS UNIT AND 6 No. 1-BED UNITS SO ALL THE WINDOW AND DOOR OPENINGS WERE BUILT IN DIFFERENT POSITIONS OR DIMENSIONS;

13 - AS GRANTED: THE PREVIOUSLY APPROVED LIFT DIDN'T INCLUDE AN ENGINE ROOM;
EXISTING: THE LIFT ENGINE ROOM WAS BUILT ACCORDING TO THE MANUFACTURER'S SPECIFICATIONS, CHANGING THE DESIGN SEEN IN THE ROOF PLAN AND ELEVATION;

14 - AS GRANTED: PROVISION OF A DOUBLE SLIDING DOOR;
EXISTING: A TRIPLE OPENING WINDOW WAS BUILT;

15 - AS GRANTED: PROVISION OF A DOUBLE SLIDING DOOR;
EXISTING: A TRIPLE SLIDING DOOR WAS BUILT;

16 - AS GRANTED: PROVISION OF A DOUBLE WINDOW;
EXISTING: A TRIPLE OPENING WINDOW WAS BUILT;

NOTE: ALL INTERNAL LAYOUTS OF THE UNITS FOR ALL FLOORS HAVE BEEN CHANGED COMPARED TO THE PREVIOUSLY APPROVED LAYOUT (AS GRANTED SCHEME). HOWEVER ONLY THE FIFTH FLOOR (PENTHOUSE) HAS SEEN A CHANGE IN THE TYPOLOGY OF THE UNITS, WHERE PREVIOUSLY APPROVED WAS 3 No. 2-BEDS UNITS AND 4 No. 1-BED UNITS, AND NOW HAS 1 No. 2-BEDS UNIT AND 6 No. 1-BED UNITS.

RETENTION

Rev	Initial	Date	Revision Description